



Cathy Burgess Interiors


151 East Main Street Suite 102 - Lexington, Kentucky 40507
859.255.9900 or 859.255.9477

DERMATOLOGY CONSULTANTS
"SUITE A"
RICHMOND, KENTUCKY

DATE: 12.16.19
SCALE: N.T.S.
DRAWN BY: MEF
REVISIONS: 12.18.19
12.19.19

PROPOSED
FLOOR PLAN

A-1

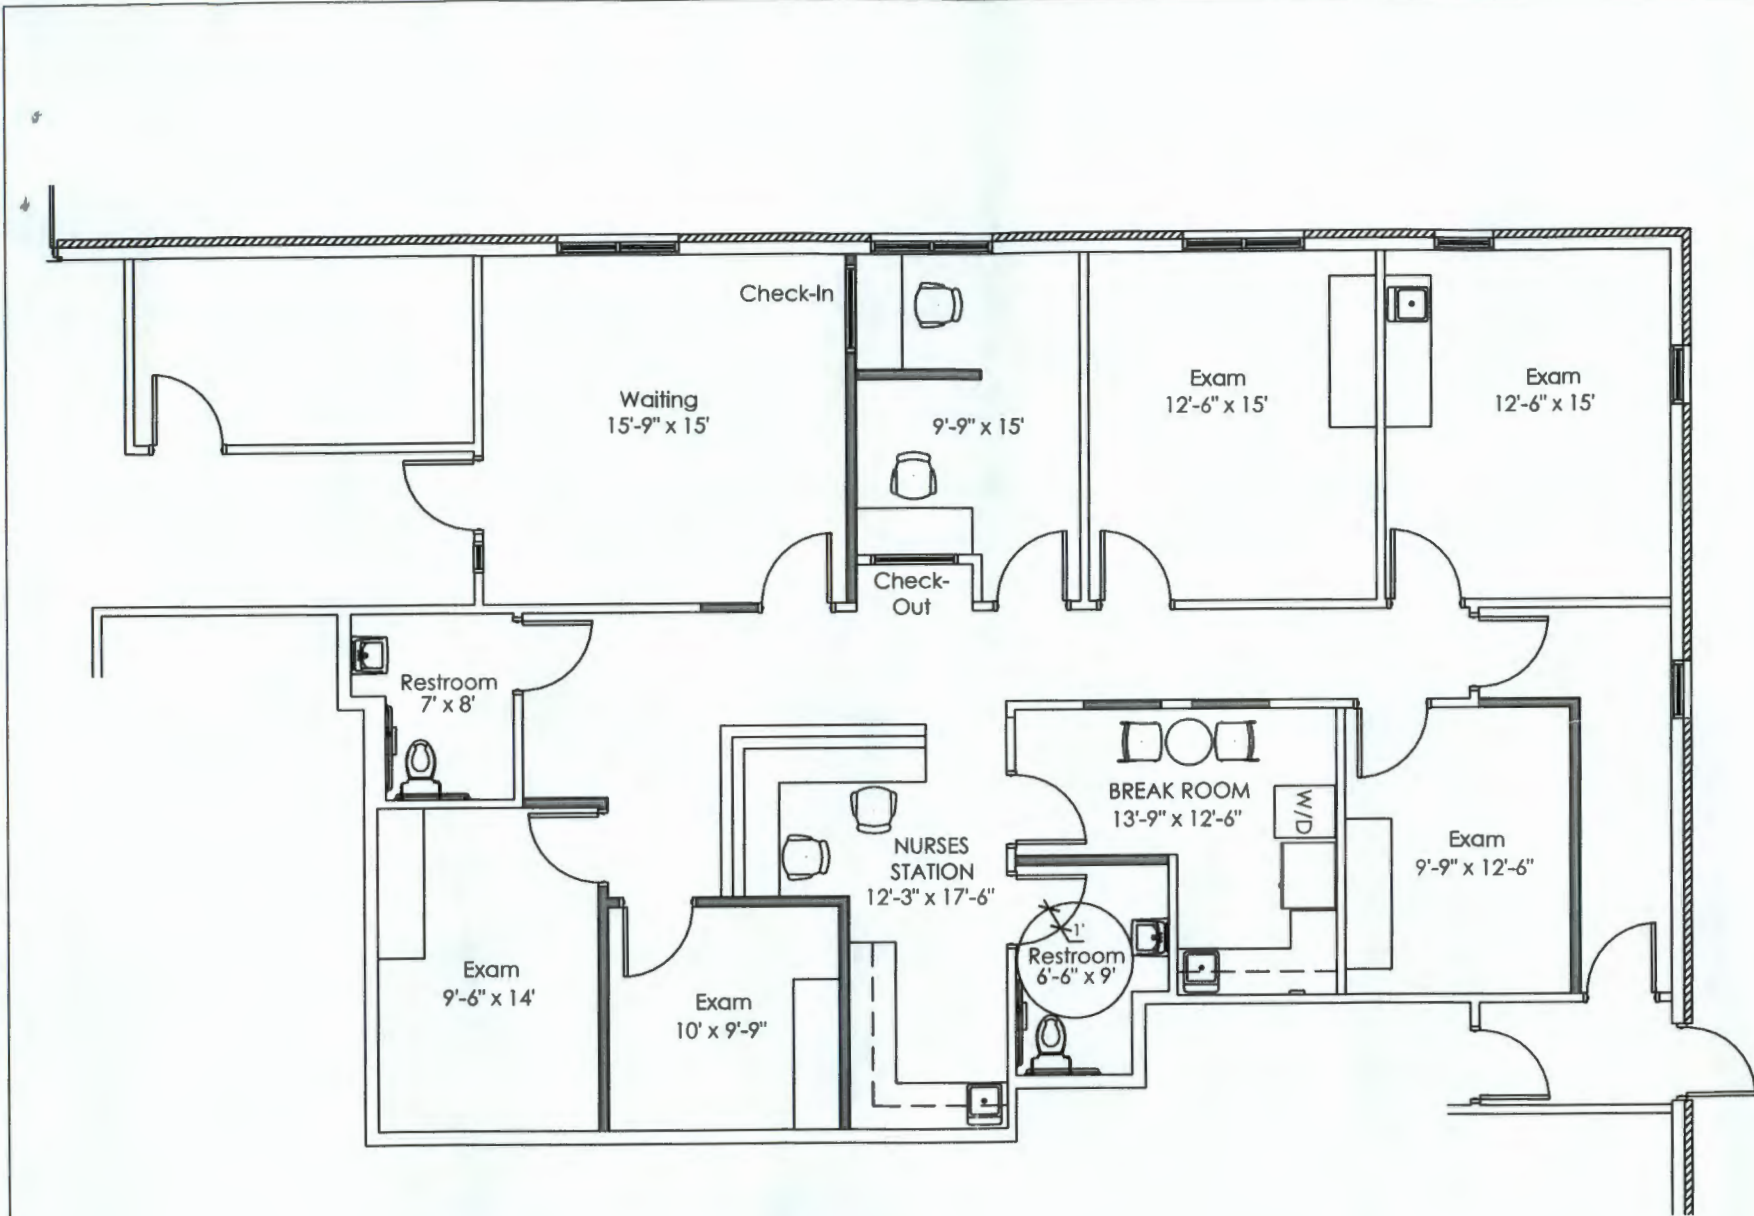


OVERALL ROOM DIMENSIONS ARE INTENDED TO REPRESENT GENERAL ROOM SIZES AND NOT FRAMING DIMENSIONS. ALL EXISTING CONDITIONS SHALL BE FIELD VERIFIED PRIOR TO CONSTRUCTION.



FILE: FLOOR CAD Floor

lwills@dermconsultants.com

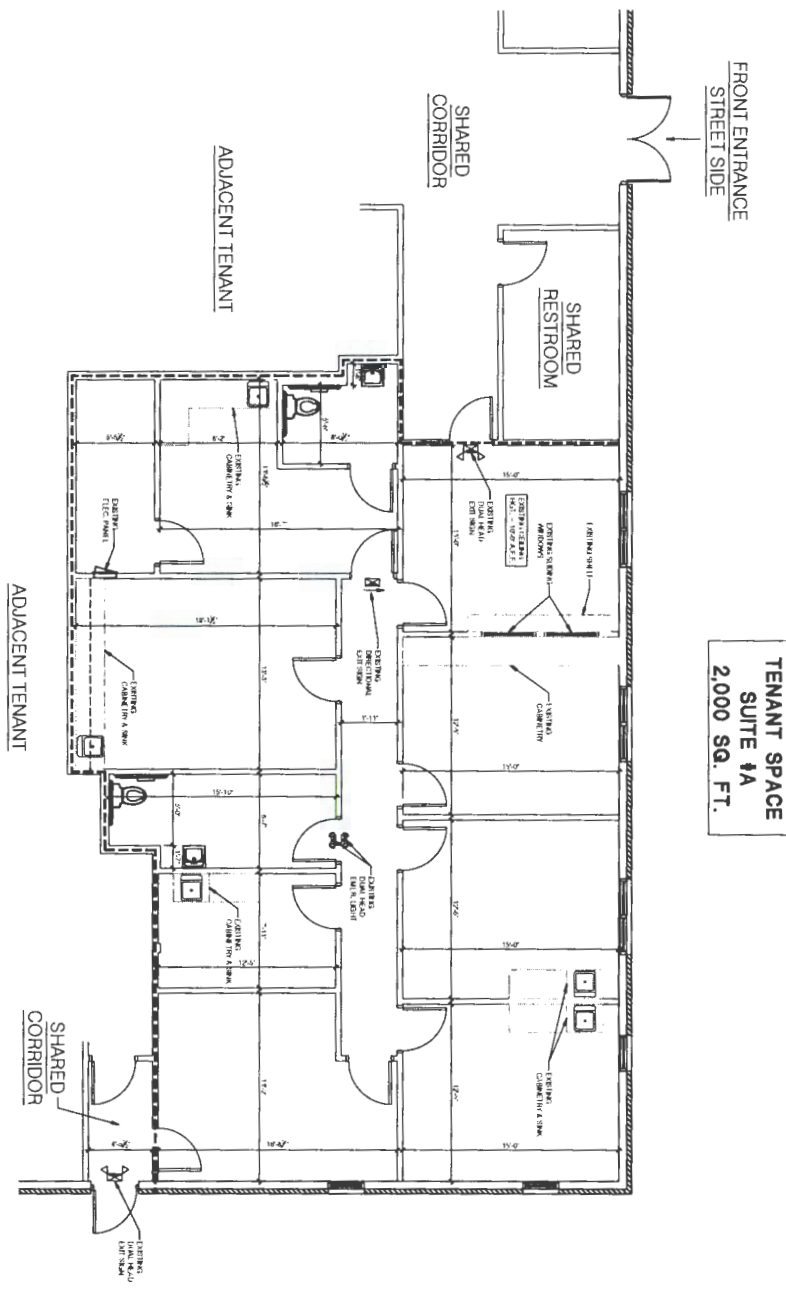

1 AS-BUILT FLOOR PLAN

TENANT SPACE
SUITE #A
2,000 SQ. FT.

PARKING

**AS-BUILT
FLOOR
PLAN**
AB1.1

LS DESIGN GROUP PLLC
LONNIE SMITH ARCHITECT
phone 859.824.3755
fax 859.824.1342
519 Hampton Way, Suite B
Richmond, KY 40475

PROJECT NAME	PROJECT NUMBER	DATE
BUILDING TYPE	ASSEMBLY	
DESIGNED BY		

Suite A



**CRAFT, NOBLE
& COMPANY**
1018 IVEL JAMES BLVD
SUITE #A
RICHMOND, KY 40475